



**Government of the Cook Islands
INFRASTRUCTURE COOK ISLANDS**

Te Tango Angaanga o te Kuki Airani

P.O. Box 102, Arorangi, Rarotonga, Cook Islands

Phone: (682) 20 321; Fax: (682) 24 321, Web: www.ici.gov.ck, Email: info@ici.gov.ck



12 February 2020

Contract: Penrhyn Island Cyclone Centres Construction
Contract No.: CK192022

RE: NOTICE TO TENDERERS 003 – Response to Tender Queries

Kia Orana,

Please find below details of NOTICE TO TENDERERS 003 – Response to Tender Queries. This Notice to Tenderers must be considered in the preparation of your Tender Submission.

Tender Closing Time

The Tender Closing Time is extended. The new Tender Closing Time is:

12:00pm (mid-day), Friday 21st February 2020 (Cook Islands Time).

Response to Tender Queries

Updated FF&E schedules

Please see attached updated FF&E schedules for Te Tautua and Omoka

Updated Tender Drawings

Please see attached updated Drawing

<u>DRAWING NO.</u>	<u>REV</u>	<u>DRAWING TITLE</u>
T 1-41	C	Te Tautua PLAN - ELECTRICAL

Material Specifications

ECOPLY BD grade 12mm thick H3.2 (CCA) – can be revised to CD grade H3.2 (CCA). Clear finish shall be 3 coats of RESENE AQUALINE Urethane Acrylic Varnish [D59]. Refer attached Resene Aquaclear waterborne urethane varnish specification.

Ceiling storage flooring ECOPLY DD grade 17mm thick H3.2 (CCA) – T&G not required, 19mm acceptable.


Request to substitute ISO standard boards instead of James Hardie boards.

Response: Please provide specification data/info for any proposed alternative materials with your tender submission. Approval is required if you wish to substitute. Please note that the fibre cement sheets are for all internal walls to reduce moisture risk and provide protection in high impact areas.

Seismic grade (500) reinforcing is required for strength and not due to Seismic activity.

89x3.5SHS Connection detail

Connection detail between the bottoms of the 89x3.5SHS G350 Post (C2) with the stairs/slab is to be as per the below detail.

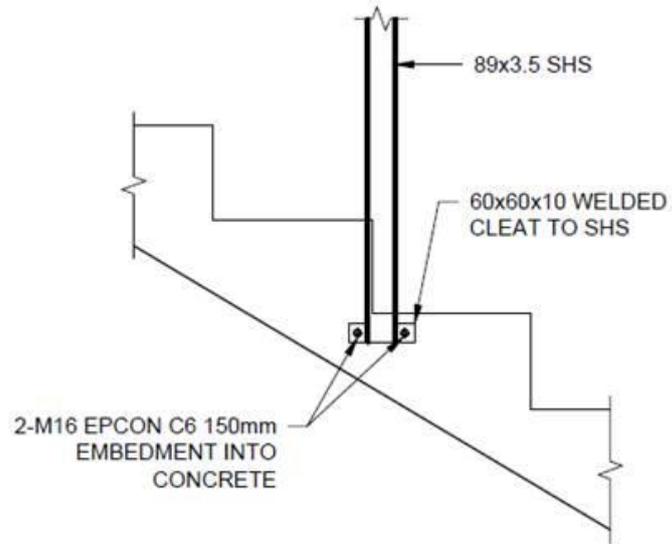


DETAILS (10)
1:20 (A1)
1:40 (A3)

NOTE:
USE SAME DETAIL AT BASE/BLOCK WALL

Stair landing connection detail

The Stair Landing to building connection detail is to be as per the below detail.

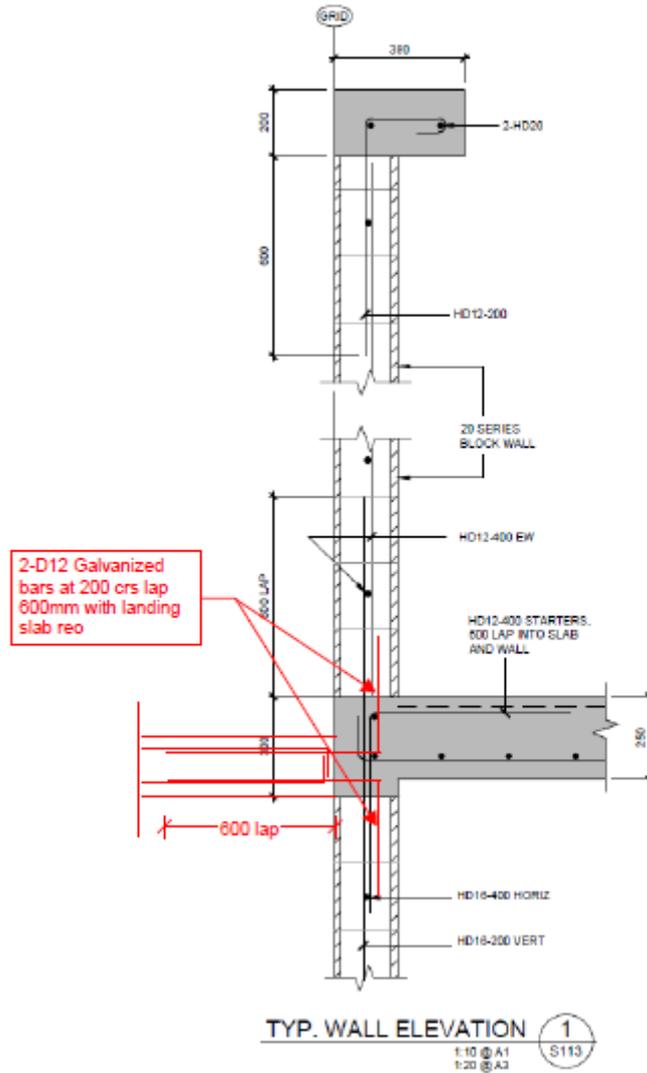

Kind regards,

Gareth Clayton

Acknowledgement: Please countersign below and return this page via email for the attention of: Solomona Solomona, Procurement and Asset Manager, Email: solomona.solomona@cookislands.gov.ck

NOTICE TO TENDERERS 003 – Response to Tender Queries

Receipt acknowledged by: _____

On behalf of: _____